


SCALA NON IMPEGNATIVA
(DO NOT SCALE)
DIMENSIONI IN
DIMENSIONS IN mm


METRIC

PROIEZIONE EUROPEA
(EUROPEAN PROJECTION)

Sezione B-B
(SECT. B-B)

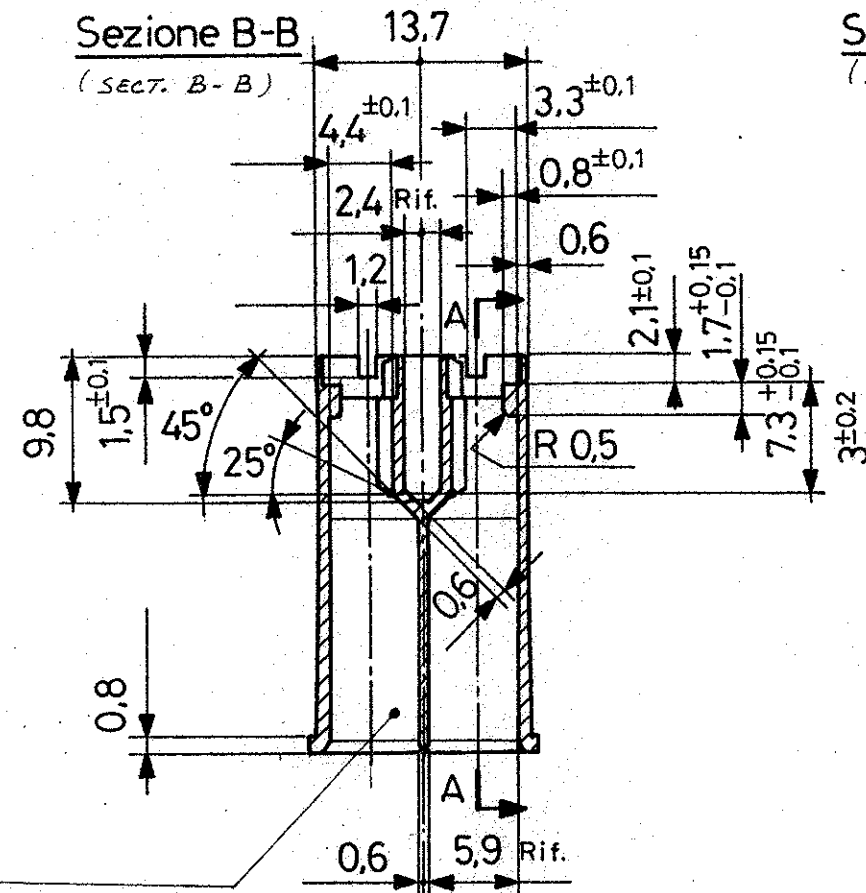


Sezione A-A
(SECT. A-A)

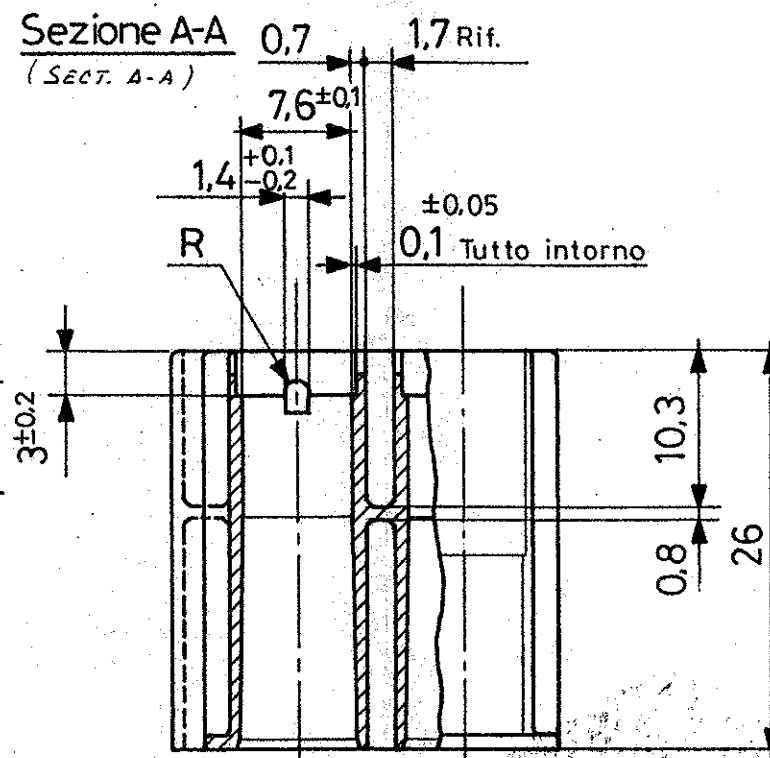

QUATTRO CAVITÀ ADATTE PER
TERMINALI POSITIVE LOCK MK I,
ES. 160759-...

FOUR CAVITIES SUITABLE FOR POSITIVE
LOCK MK I REC. CONTACT,
E.G. P/N 160759-...

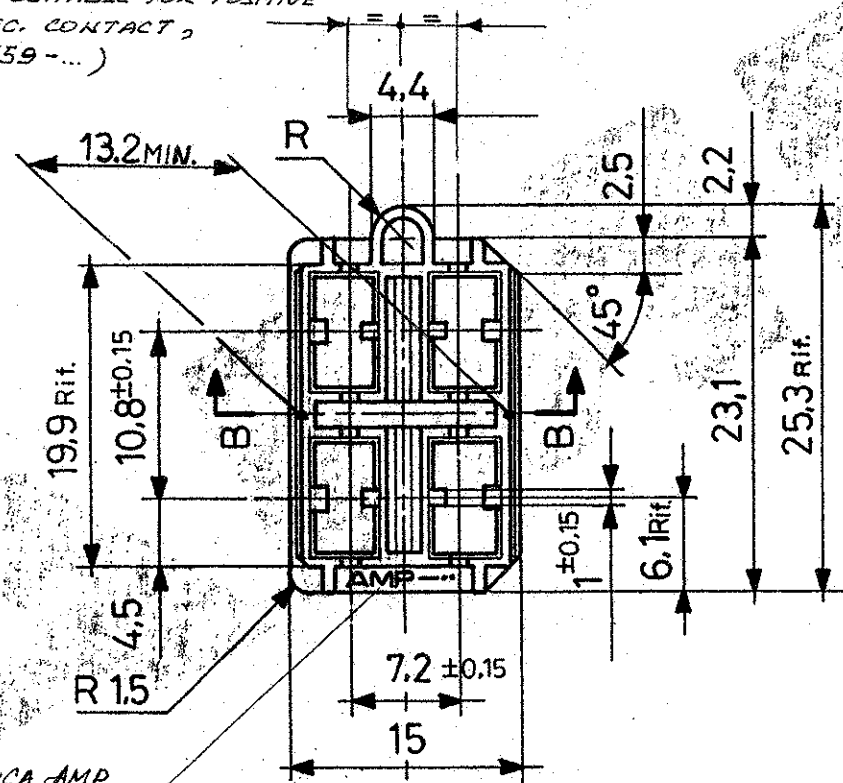

MARCHIO DI FABBRICA AMP
(AMP TRADE MARK)

OBSOLETE
OBSOLETE

~~Verde (GREEN)~~
~~Rosso (RED)~~
~~Nero (BLACK)~~
~~Naturale (CLEAR)~~

Poliammide 6.6
(PA 6.6 UNFILLED)

~~281889-4~~
~~281889-3~~
281889-2
281889-1

CUSTOMER DWG.
FOR REFERENCE ONLY

DISEGNO PER CLIENTE
SOLO PER RIFERIMENTO

THIS DRAWING IS UNPUBLISHED

RELEASE FOR PUBLICATION

1988

© COPYRIGHT 1988 BY AMP INCORPORATED, HARRISBURG, PA. ALL INTERNATIONAL RIGHT
RESERVED AMP PRODUCTS MAY BE COVERED BY U.S. AND FOREIGN PATENT AND/OR PATENT PENDING

TOLLERANZE: SE NON
DIVERSAMENTE SPECIFICATO
(TOLERANCES UNLESS OTHERWISE
SPECIFIED)

DIAM. ISOLANTE
(INS. DIA. RANGE)

RANGO FILO
(WIRE RANGE)

SCALA
(SCALE)

± 0.3

ANGOLI
(ANGLES) ± 2°

AMP

AMP ITALIA S.p.A.
Corso F.lli Cervi, 15
COLLEGNO (TORINO)

DIS. (DR.)
Bassano 29-Feb. 88

DESCRIZIONE (DESCRIPTION)
4 Pos. Positive Lock MK-I-
Rec. Hsg. (.250 Srs.)

LOC.

SIZE

NUMERO
(DWG NO.)

IA3 C-281889

REV.

B1

FOLIO
(SHEET)
1 OF 1