
THIS DRAWING IS UNPUBLISHED. RELEASED FOR PUBLICATION -,- .
© COPYRIGHT - By - ALL RIGHTS RESERVED.


LOC	DIST
AD	00


REVISIONS


P	LTR	DESCRIPTION	DATE	DWN	APVD
	B	ECR-13-018647	14MAR2014	W.W	C.W

1. RECEPTACLE ACCEPTS A .008-.014 THICK I.C. LEAD.
2. TUBE LOADED FOR AUTOMATIC INSERTION.
3. BECU CONTACT-PLATED WITH TWO .000030 MIN THK. GOLD STRIPES IN CONTACT AREA WITH TIN ON CONTACT LEGS, BALANCE OF CONTACT NICKEL PLATED.
4. PHOS. BRONZE CONTACT- PLATED WITH TWO .000015 MIN THK. GOLD STRIPES IN CONTACT AREA WITH TIN ON CONTACT LEGS, BALANCE OF CONTACT NICKEL PLATED.
5. MAXIMUM DIMENSION FOR I.C. SEATING PLANE.
6. HOUSING MATERIAL-GLASS FILLED THERMOPLASTIC, BLACK, 94V-0

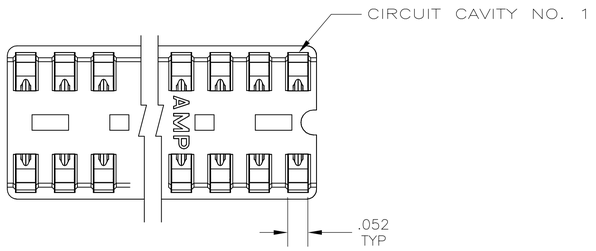


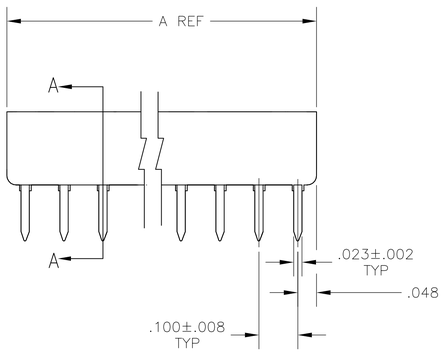

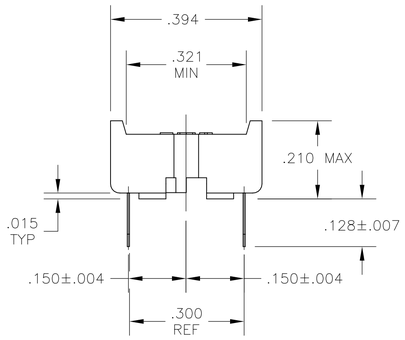

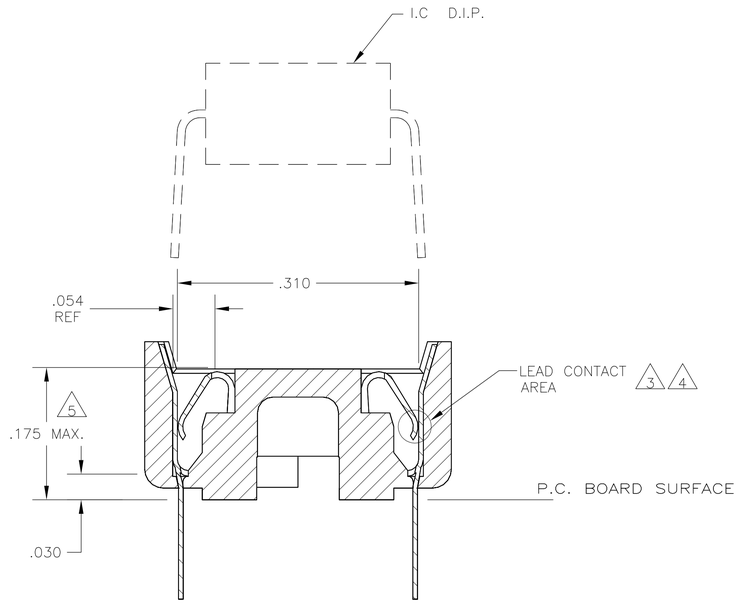

SECTION A-A
SCALE 10:1

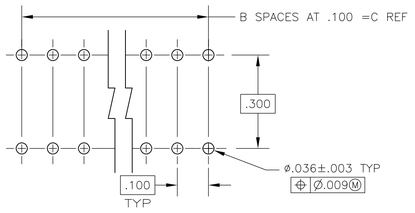

RECOMMENDED MOUNTING HOLE PATTERN
SCALE 4:1

		CONTACT & FINISH	DIM C	B SPCS	DIM A	POSITION	PART NO.
		3	.900	9	.995	20	1-1825093-6
		3	.800	8	.895	18	1-1825093-5
		3	.700	7	.795	16	1-1825093-4
		3	.600	6	.695	14	1-1825093-3
		3	.300	3	.395	8	1-1825093-2
Ⓑ	OBSOLETE	~~3~~	~~.200~~	~~2~~	~~.295~~	~~6~~	~~1-1825093-1~~
		4	.900	9	.995	20	1825093-6
Ⓑ	OBSOLETE	~~4~~	~~.800~~	~~8~~	~~.895~~	~~18~~	~~1825093-5~~
		4	.700	7	.795	16	1825093-4
		4	.600	6	.695	14	1825093-3
		4	.300	3	.395	8	1825093-2
Ⓑ	OBSOLETE	~~4~~	~~.200~~	~~2~~	~~.295~~	~~6~~	~~1825093-1~~

THIS DRAWING IS A CONTROLLED DOCUMENT.

DIMENSIONS: INCHES

TOLERANCES UNLESS OTHERWISE SPECIFIED:
0 PLC ± -
1 PLC ± -
2 PLC ± -
3 PLC ± -
4 PLC ± -
ANGLES ± -

MATERIAL -
FINISH -

DWN B.S.VISWESWARA 20APR2005
CHK K.WRIGHT -
APVD - -
PRODUCT SPEC -
APPLICATION SPEC -
WEIGHT -

TE Connectivity

NAME DIP SOCKET ASSY, CLOSED, DIPLOMATE, .300 CL, LEAD FREE -

SIZE	CAGE CODE	DRAWING NO	RESTRICTED TO
A1	00779	C-1825093	-

CUSTOMER DRAWING | SCALE 5:1 | SHEET 1 OF 1 | REV B