
THIS DRAWING IS UNPUBLISHED. RELEASED FOR PUBLICATION 2007
© COPYRIGHT 2007 - ALL RIGHTS RESERVED.

STRIP FORM
Bandware

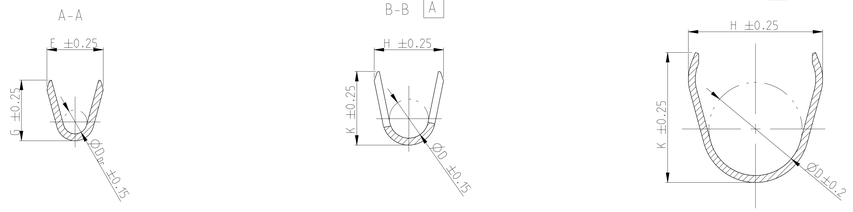

1 CONTACT AREA PRE SILVER MIN. 3 µm
CANTILEVER SPRING PLAIN
Kontaktzone vorversilbert min. 3 µm
Ueberfeder blank

2 CONTACT BODY Ni-PLATING MIN. 0.5 µm; CONTACT AREA PRE-GOLD MIN. 0.6 µm
OVER NICKEL; CRIMP AREA PRE-TIN
CANTILEVER SPRING PLAIN
Kontaktkoerper vernickelt min. 0.5 µm; Kontaktzone vorvergoldet min. 0.6 µm ueber Nickel
Crimpzone vorverzinnt; Ueberfeder blank

3 IN THIS AREA CRACK SHAPING AT THE SURFACE PERMISSIBLE
In diesem Bereich Rissbildung in der Oberflaeche zulaessig

4 PRE-TIN MIN. 1 µm; CANTILEVER SPRING PLAIN
vorverzinnt min. 1 µm; Ueberfeder blank

5 AWG 12 TXL 828905-1 OR / oder 282536-1
AWG 12 GXL 638865-1

6 ATTENTION! CONSTRUCTION OF THE CONTACT CAVITY IN THE AREA
OF THE SINGLE WIRE SEAL IS Ø6.4 +0.1 -0.05
Achtung! Die Kammer ist im Bereich der Einzeldichtung
auf Ø6.4 +0.1 -0.05 auszulegen

7 PUNCHED WITH VOLATILIZING STAMPING-OIL
Gestanzt mit verfluechtigendem Stanzoel

8 OPTIONAL
optioanl


								SEE / siehe SECTION A-A Schnitt A-A	SEE / siehe SECTION B-B Schnitt B-B										
SINGLE WIRE SEAL / Einzeldichtungssystem	1-1719504-2	A	4	CuSn4	⚠	12 AWG	max. 3.0	E = 4.0 G = 4.2 D_{Dr} = 2.0	A H = 5.3 K = 5.0 D = 3.6	1852291-3	-	3.5	6.0	7.6	26.8	⚠	828922-1		
	1-1719504-1	A	4		⚠														
	3-968947-1	A	6	CuSn0.20	⚠	>2.5 - 4.0 FLR	max. 3.7	E = 4.5 G = 4.7 D_{Dr} = 2.3	B H = 6.2 K = 6.0 D = 4.3	MQC APPLICATOR 2-541537-2	539635-1 MATRIZE : 539727-2	4.3	6.9	8.5	28.5	828985 (Ø6.4) ⚠	828986-1		
	2-968947-1	A	6	CuFe	⚠														
	1-968947-2	A	6	CuSn4	⚠														
	1-968947-1	A	6		⚠														
	2-962916-3	E	4	CuFe	⚠	>1.0 - 2.5 FLR	max. 3.0	E = 3.6 G = 3.8 D_{Dr} = 1.7	A H = 5.3 K = 5.0 D = 3.6	MQC APPLICATOR 2-878560-2	734440-1	3.5	6.0	7.6	26.8	828905 (Ø5.0)	828922-1		
	2-962916-2	E	4		⚠														
	2-962916-1	E	4		⚠														
	1-962916-3	E	4	CuSn4	⚠														
	1-962916-2	E	4		⚠														
	1-962916-1	E	4		⚠														
	2-962915-3	E	4	CuFe	⚠	0.5 - 1.0 FLR	max. 2.1	E = 2.6 G = 2.9 D_{Dr} = 1.2	A H = 5.0 K = 4.8 D = 3.3	MQC APPLICATOR 2-878559-2	734438-1	3.0	5.4	7.0	26.8	828904 (Ø5.0)			
	2-962915-2	E	4		⚠														
	2-962915-1	E	4		⚠														
	6-962915-6	E	4	CuSn4	⚠⚠														
	1-962915-3	E	4		⚠														
	1-962915-2	E	4		⚠														
	1-962915-1	E	4		⚠														
	5-965982-1	A	8	CuSn4	⚠	0.2 - 0.5 FLR	max. 2.1	E = 2.1 G = 2.1 D_{Dr} = 0.8	A H = 4.7 K = 4.5 D = 3.2	MQC APPLICATOR 2-878558-2	539635-1 MATRIZE : 539737-2	2.5	4.9	6.5	26.8	828904 (Ø5.0)			
	1-965982-3	A	5		⚠														
	~~1-965982-1~~	~~A~~	~~5~~		⚠													5-965982-1	A19
UNSEALED / ungedichtet	3-968946-1	A	3	CuSn0.20	⚠	>2.5 - 4.0 FLR	2.7 - 3.7	E = 4.5 G = 4.7 D_{Dr} = 2.3	A H = 5.7 K = 5.9 D = 3.3	MQC APPLICATOR 2-541534-2	539635-1 MATRIZE : 539723-2	4.3	6.6	8.5	28.5				
	2-968946-2	A	3	CuFe	⚠														
	2-968946-1	A	3		⚠														
	~~1-968946-2~~	~~A~~	~~3~~	CuSn4	⚠													2-968946-2	A19
	1-968946-1	A	3		⚠														
	2-962843-3	C	1	CuFe	⚠	>1.0 - 2.5 FLK	2.4 - 3.7	E = 3.6 G = 3.8 D_{Dr} = 1.7	A H = 5.5 K = 5.7 D = 3.2	MQC APPLICATOR 2-878552-2	734417-3	3.6	5.2	8.9	28.6				
	2-962843-2	C	1		⚠														
	2-962843-1	C	1		⚠														
	1-962843-3	C	1	CuSn4	⚠														
	1-962843-2	C	1		⚠														
	1-962843-1	C	1		⚠														
	2-962842-3	E	1	CuFe	⚠	>1.0 - 2.5 FLR	2.1 - 2.9	E = 3.6 G = 3.8 D_{Dr} = 1.7	A H = 4.3 K = 4.5 D = 2.6	MQC APPLICATOR 2-878551-2	734417-2	3.6	5.2	8.2	27.9				
	2-962842-2	F	1		⚠														
	2-962842-1	E	1		⚠														
	1-962842-3	E	1	CuSn4	⚠														
	1-962842-2	E	1		⚠														
	1-962842-1	E	1		⚠														
	2-962841-3	F	1	CuFe	⚠	0.5 - 1.0 FLR	1.4 - 2.1	E = 2.6 G = 2.8 D_{Dr} = 1.1	A H = 3.2 K = 3.4 D = 1.8	MQC APPLICATOR 2-878550-2	734417-1	3.0	4.6	7.0	26.7				
	2-962841-2	F	1		⚠														
	2-962841-1	F	1		⚠														
	1-962841-3	F	1	CuSn4	⚠														
	1-962841-2	F	1		⚠														
	1-962841-1	F	1		⚠														
	2-963860-3	B	2	CuFe	⚠	0.2 - 0.5 FLR	1.3 - 1.6	E = 2.1 G = 2.1 D_{Dr} = 0.8	A H = 2.9 K = 2.9 D = 1.4	MQC APPLICATOR 2-878549-2	734538-1	2.5	3.7	5.8	25.5				
	2-963860-2	B	2		⚠														
	2-963860-1	B	2		⚠														
	5-963860-2	A	7	CuSn4	⚠														
	5-963860-1	A	7		⚠														
	1-963860-3	B	2		⚠														
	~~1-963860-2~~	~~B~~	~~2~~		⚠													5-963860-2	A19
	~~1-963860-1~~	~~B~~	~~2~~		⚠													5-963860-1	A19
	TE ORDER-NO. STRIPFORM Bandware	REV	DESIGN Ausfuehrung	MATERIAL Werkstoff	SURFACE Oberflaeche	DGB mm²	INSULATIONØ Isolationsø mm	STRIP FORM WIRE CRIMP Drahtcrimp / INSUL. CRIMP Isolationscrimp Bandware — CRIMP DIMENSION mm Crimpabmessungen mm	APPLICATION TOOL Anschlagwerkzeug / HAND TOOL Handzange — EXTRACTION TOOL Ausdrueckwerkzeug No. 968107-1			A	B	C	D	TE ORDER-NO. SINGLE WIRE SEAL Einzeldichtungssystem (CAVITY DIAMETER) (Kammerdurchmesser)	TE ORDER-NO. SEALING PLUG Blindstopfen	SUPERSEEDED BY Ersetzt durch	

REVISIONS


P	LTR	DESCRIPTION	DATE	DWN	APVD
	A16	Designs adapted. Crimp height to PN 962863 added. Drawing corrected.	01OCT2012	Kirs.	Mertz
	A17	ECR-15-012070	13AUG2015	JBJH	BK
	A18	Added PN 5-963860-1, 5-963860-2 and 5-965982-1, new design 7 and 8	19NOV2020	FRAN	MERZ
	A19	1-965982-1, 1-963860-1,1-963560-2 and 1-968946-2 is superseded	09JUN2026	MM	MP

FLR-/FLK-WIRE
FLR-/FLK-Leitung


DESIGN 1
Ausfuehrung 1

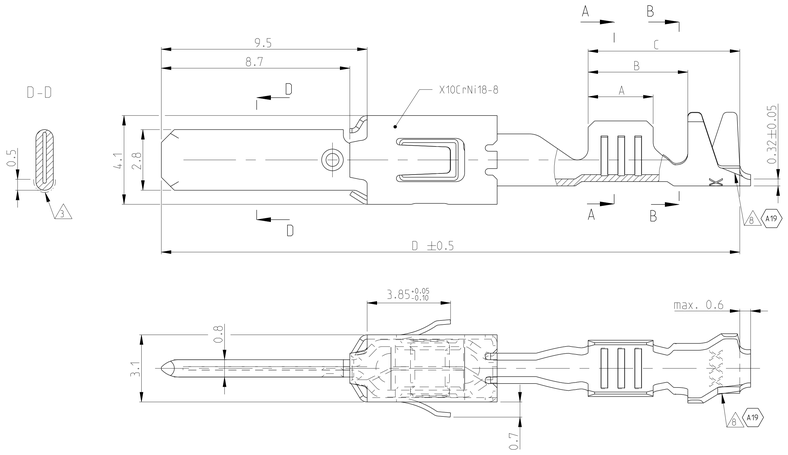

DESIGN 2
Ausfuehrung 2

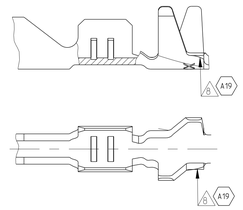


DESIGN 3
Ausfuehrung 3

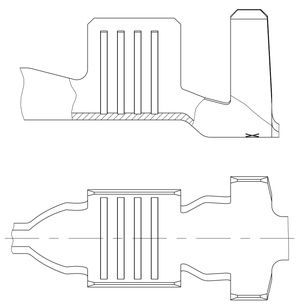


SINGLE WIRE SEAL
Einzeldichtungssystem


DESIGN 4
Ausfuehrung 4

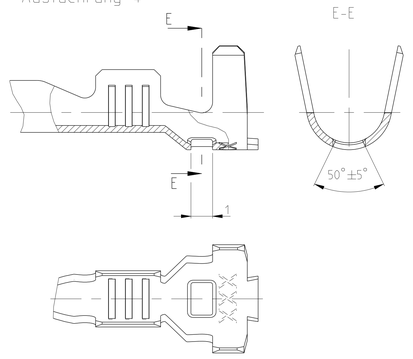


DESIGN 5
Ausfuehrung 5

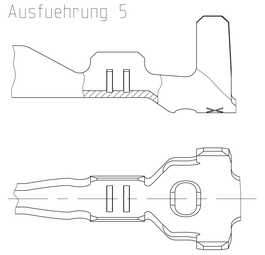


DESIGN 6
Ausfuehrung 6

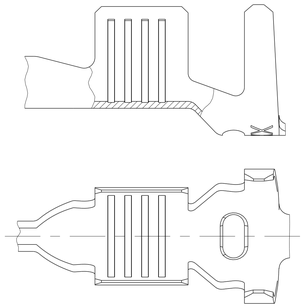

DESIGN 7
Ausfuehrung 7

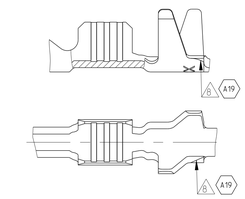

DESIGN 8
Ausfuehrung 8

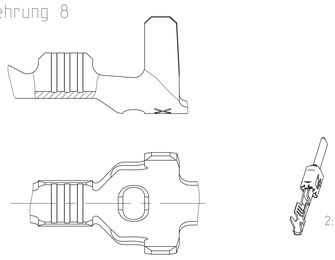

THIS DRAWING IS A CONTROLLED DOCUMENT.	DRN 14.JUN1999 A.Gerlach	TE Connectivity	
DIMENSIONS: mm	TOLERANCES UNLESS OTHERWISE SPECIFIED: 0 PLC ±- 1 PLC ±- ±0.2 2 PLC ±- 3 PLC ±- 4 PLC ±- ANGLES ±1.5°	M.Bleicher APVD -	NAME PRODUCT GROUP DRAWING FOR TAB 2.8x0.8 Produktgruppenzeichnung fuer Flachstecker 2.8x0.8
MATERIAL - -	FINISH - -	PRODUCT SPEC 108-18063 APPLICATION SPEC 114-18051 WEIGHT -	SIZE A0 CAGE CODE 00779 DRAWING NO C=1355052 RESTRICTED TO -
		Customer Drawing	SCALE 10:1 SHEET 1 OF 1 REV A19

4806 (3/13)