
© 2023 TE Connectivity. All Rights Reserved.


REVISIONS					
P	LTR	DESCRIPTION	DATE	DWN	APVD
	D2	OBSOLETING THE PN 1-1546566-3,1-1546566-5 AND 1-1546566-7	29SEP2023	SP	PS


MATERIALS:
HOUSING: THERMOPLASTIC, UL94V-0, BLACK.
TERMINAL: BRIGHT TIN PLATED COPPER ALLOY.
SCREWS: 8-32, ZINC PLATED STEEL.

ELECTRICAL:
CURRENT RATING: 30A
VOLTAGE RATING: 600V
WIRE RANGE: 10-18 AWG (UL)
10-22 AWG (CSA)


MECHANICAL:
RECOMMENDED TORQUE: 20 IN-LB.
OPERATING TEMP.: -40°C TO +120°C.

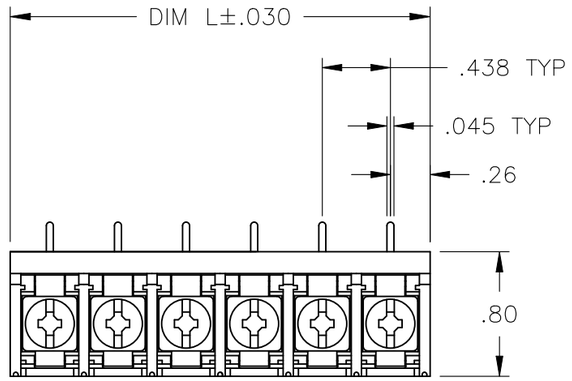

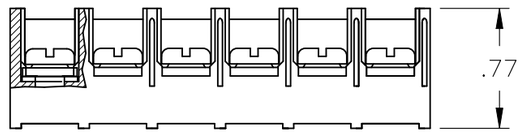

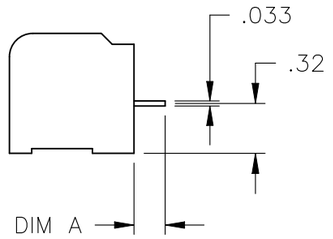

	DIM A +.020/-.010	DIM L	NO OF POS	TE NUMBER	TE NUMBER
	.126	4.010	9	8PCR-09-006A	2-1546566-1
	.200	8.823	20	8PCR-20-006	2-1546566-0
	.200	8.385	19	8PCR-19-006	1-1546566-9
	.200	7.948	18	8PCR-18-006	1-1546566-8
OBSOLETE	~~.200~~	~~7.510~~	~~17~~	~~8PCR-17-006~~	~~1-1546566-7~~
	.200	7.073	16	8PCR-16-006	1-1546566-6
OBSOLETE	~~.200~~	~~6.635~~	~~15~~	~~8PCR-15-006~~	~~1-1546566-5~~
	.200	6.198	14	8PCR-14-006	796875-3
OBSOLETE	~~.200~~	~~5.760~~	~~13~~	~~8PCR-13-006~~	~~1-1546566-3~~
	.200	5.323	12	8PCR-12-006	1-1546566-2
	.200	4.885	11	8PCR-11-006	796875-1
	.200	4.448	10	8PCR-10-006	5-1546159-4
	.200	4.010	9	8PCR-09-006	1546566-9
	.200	3.573	8	8PCR-08-006	4-1437657-3
	.200	3.135	7	8PCR-07-006	5-1546159-2
	.200	2.698	6	8PCR-06-006	3-1437657-7
	.200	2.260	5	8PCR-05-006	3-1437657-3
	.200	1.823	4	8PCR-04-006	3-1437657-1
	.200	1.385	3	8PCR-03-006	2-1437657-8
	.200	.948	2	8PCR-02-006	2-1437657-2

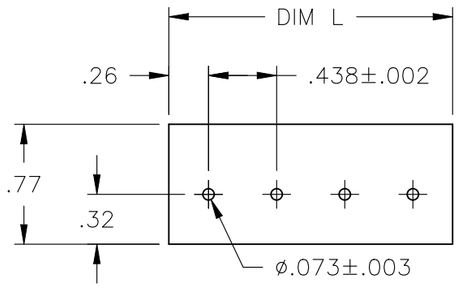

RECOMMENDED PCB LAYOUT

THIS DRAWING IS A CONTROLLED DOCUMENT.

DIMENSIONS: INCHES

TOLERANCES UNLESS OTHERWISE SPECIFIED:
0 PLC ± –
1 PLC ± –
2 PLC ± .01
3 PLC ± .005
4 PLC ± –
ANGLES ± 1°

MATERIAL –

FINISH –

DWN S SCHLEGEL 10/25/06
CHK S. YODER 10/25/06
APVD S. YODER 10/25/06
PRODUCT SPEC —
APPLICATION SPEC —
WEIGHT

TE Connectivity

NAME 8PCR-XX-006 ASSEMBLY

SIZE	CAGE CODE	DRAWING NO	RESTRICTED TO
A3	00779	C-2-1437657-2	—

CUSTOMER DRAWING

SCALE 1:1 SHEET 1 OF 1 REV D2