

THIS DRAWING IS UNPUBLISHED. RELEASED FOR PUBLICATION –,– .
© COPYRIGHT – By – ALL RIGHTS RESERVED.

REVISIONS

P	LTR	DESCRIPTION	DATE	DWN	APVD
	K	REVISED PER ECO–16–011204	29AUG2016	AP	DG

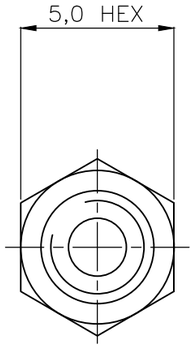

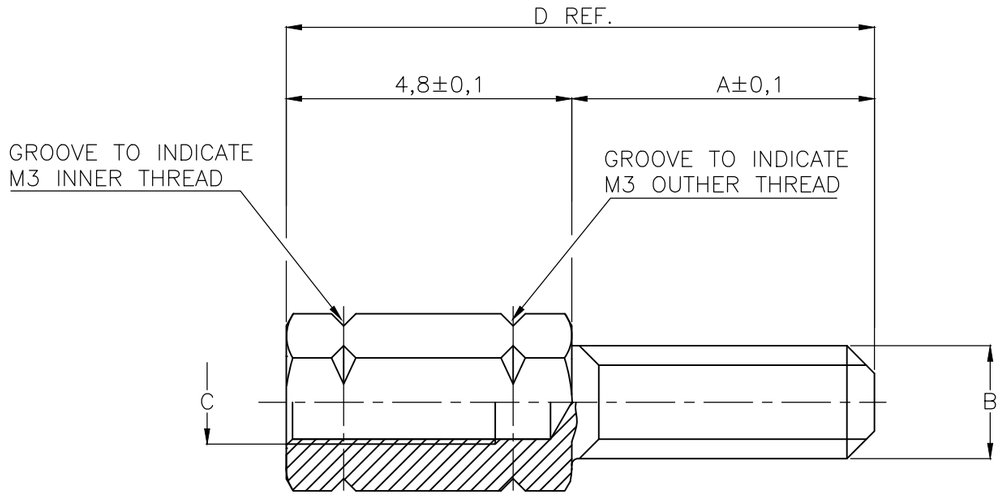

	DIM "D"	DIM "C"	DIM "B"	DIM "A"	FINISH	MATERIAL	PART NUMBER
1 OBSOLETE	10,8	4–40 UNC	4–40 UNC	6,0	TINPLATED	BRASS	~~3–829261–0~~
1 OBSOLETE	9,8	M3	4–40 UNC	5,0			~~2–829261–8~~
		4–40 UNC	M3	5,0			2–829261–6
		M3	M3	5,0			2–829261–4
		4–40 UNC	4–40 UNC	5,0			2–829261–2
1 OBSOLETE	19,0	M3	4–40 UNC	14,2			~~1–829261–8~~
		4–40 UNC	M3	14,2			1–829261–6
		M3	M3	14,2			1–829261–4
OBSOLETE		4–40 UNC	4–40 UNC	14,2			1–829261–2
	12,7	M3	4–40 UNC	7,9			829261–8
		4–40 UNC	M3	7,9			829261–6
OBSOLETE		M3	M3	7,9			~~829261–4~~
		4–40 UNC	4–40 UNC	7,9			829261–2

1 OBSOLETE PARTS: OBSOLETE CIS STREAMLINING
PER D.RENAUD/D.SINISI

THIS DRAWING IS A CONTROLLED DOCUMENT.

DIMENSIONS: mm

TOLERANCES UNLESS OTHERWISE SPECIFIED:
0 PLC ± –
1 PLC ± 0,2
2 PLC ± –
3 PLC ± –
4 PLC ± –
ANGLES ± –

MATERIAL –

FINISH –

DWN D.KESSLER 02APR91
CHK C.V.TILBURG 23APR91
APVD L.V.SOEST 25APR91
PRODUCT SPEC —
APPLICATION SPEC —
WEIGHT 0

TE Connectivity

NAME
SCREWLOCK, FEMALE HD–SERIES
–
–

SIZE	CAGE CODE	DRAWING NO	RESTRICTED TO
A3	00779	C–829261	—

CUSTOMER DRAWING | SCALE NTS | SHEET 1 OF 1 | REV K